



공사명 PROJECT TITLE

연세대 백주년기념관
콘서트홀 리모델링
공사 중 정보통신공사
(음향/영상/무대)

비 고 REMARKS



서울시 마포구 동교동로 134 동수빌딩 5층
T : 02-332-3329(10) F : 02-325-4432

중 합 설 계 안 : 제 서품E-1-043 호
건축전기설비기술사 이 성 욱

제 도 DRAWN BY

검 사 CHECKED BY

협 의 CONSULT

△ / /
△ / /
승 인 APPROVED BY

축 척 SCALE

A3:1/250(A1:1/125)

날 짜 DATE


2013. 3. 2

도면명 준공도면

콘서트홀 1층 SOUND
SYSTEM WIRING PLAN

도면번호 SHEET NO

A-013

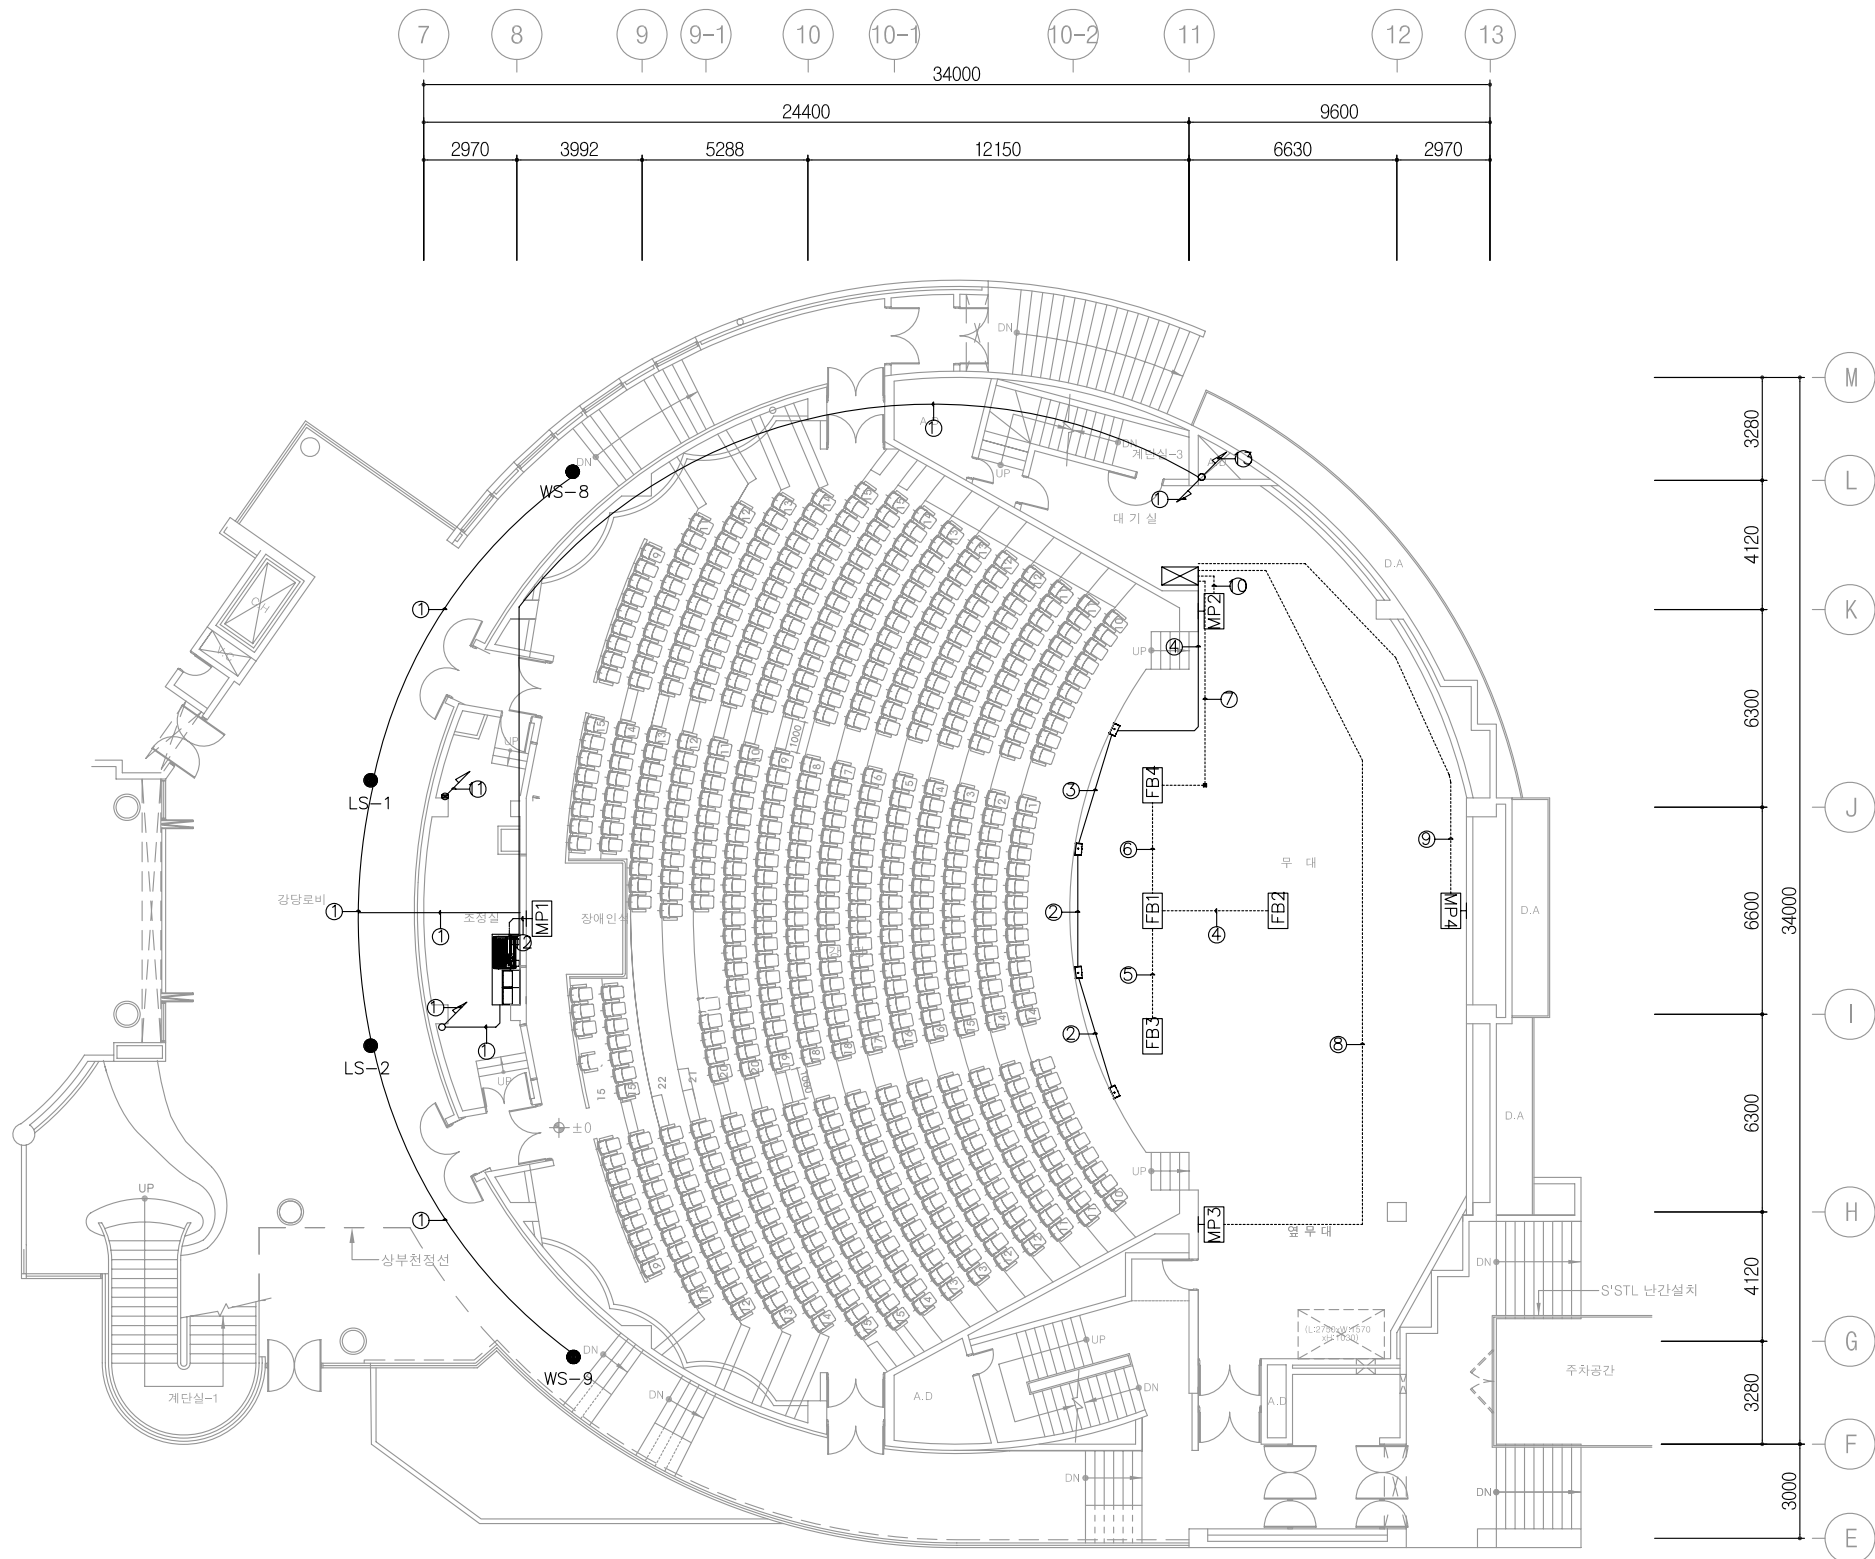

Wire & Conduit Chart				
Cord	Conduit Size	Description	Remark	
1	16C	5100UP x 1	Speaker	To. ???
2	16C	5100UP x 1	Speaker	To. Stage Rack
3	28C	5100UP x 2	Speaker	To. Stage Rack
4	28C	1192A x 4	Mic	To. Stage Rack
5	28C	1192A x 2	Mic	To. Stage Rack
	28C	5100UP x 2	Speaker	To. Stage Rack
6	36C	1192A x 6	Mic	To. Stage Rack
	28C	5100UP x 2	Speaker	To. Stage Rack
7	36C x 2	1192A x 12	Mic	To. Stage Rack
	28C	5100UP x 4	Speaker	To. Stage Rack
8	28C	1513C x 1	Mic	To. Stage Rack
	28C x 2	1513C x 2	Mic/Line	To. Stage Rack
9	22C	VCTF 2.5SQ/3C x 1	Power	To. Stage Rack

Wire & Conduit Chart				
Cord	Conduit Size	Description	Remark	
10	28C x 3	1513C x 3	Mic/Line	To. Stage Rack
	22C	VCTF 2.5SQ/3C x 1	Power	To. Stage Rack
11	28C	MADI Cable x 1	MADI	To. Stage Rack
	16C	1583A x 2	UTP	To. Stage Rack
	28C x 2	1513C x 2	Mic/Line	To. MP-1
12	28C	MADI Cable x 1	MADI	To. MP-1
	22C	VCTF 4.0SQ/3C x 1	Power	To. MP-1
	36C x 2	1192A x 12	Mic	To. Stage Rack
	28C	5100UP x 4	Speaker	To. Stage Rack
	28C x 3	1513C x 3	Mic/Line	To. Stage Rack
	22C	VCTF 2.5SQ/3C x 1	Power	To. Stage Rack
	28C	MADI Cable x 1	MADI	To. Stage Rack
13	16C	1583A x 2	UTP	To. Stage Rack

025
A | 03

콘서트홀 1층 SOUND SYSTEM LAYOUT PLAN

SCALE : 1/250