



공사명 PROJECT TITLE

연세대 백주년기념관  
콘서트홀 리모델링  
공사 중 정보통신공사  
(음향/영상/무대)

비 고 REMARKS



서울시 마포구 동대문로 134 동수빌딩 5층  
T : 02-352-3329(10) F : 02-325-4432

등록설계번호 : 제 서플E-1-043 호  
건축전기설비기술사 이 성 욱

제 도 DRAWN BY

검 사 CHECKED BY

협 의 CONSULT

△ / /  
△ / /  
승 인 APPROVED BY

축 척 SCALE

A3:1/250(A1:1/125)

날 짜 DATE


2013. 3. 2

도면명 준공도면

콘서트홀 1층 SOUND  
SYSTEM LAYOUT PLAN

도면번호 SHEET NO

A-008

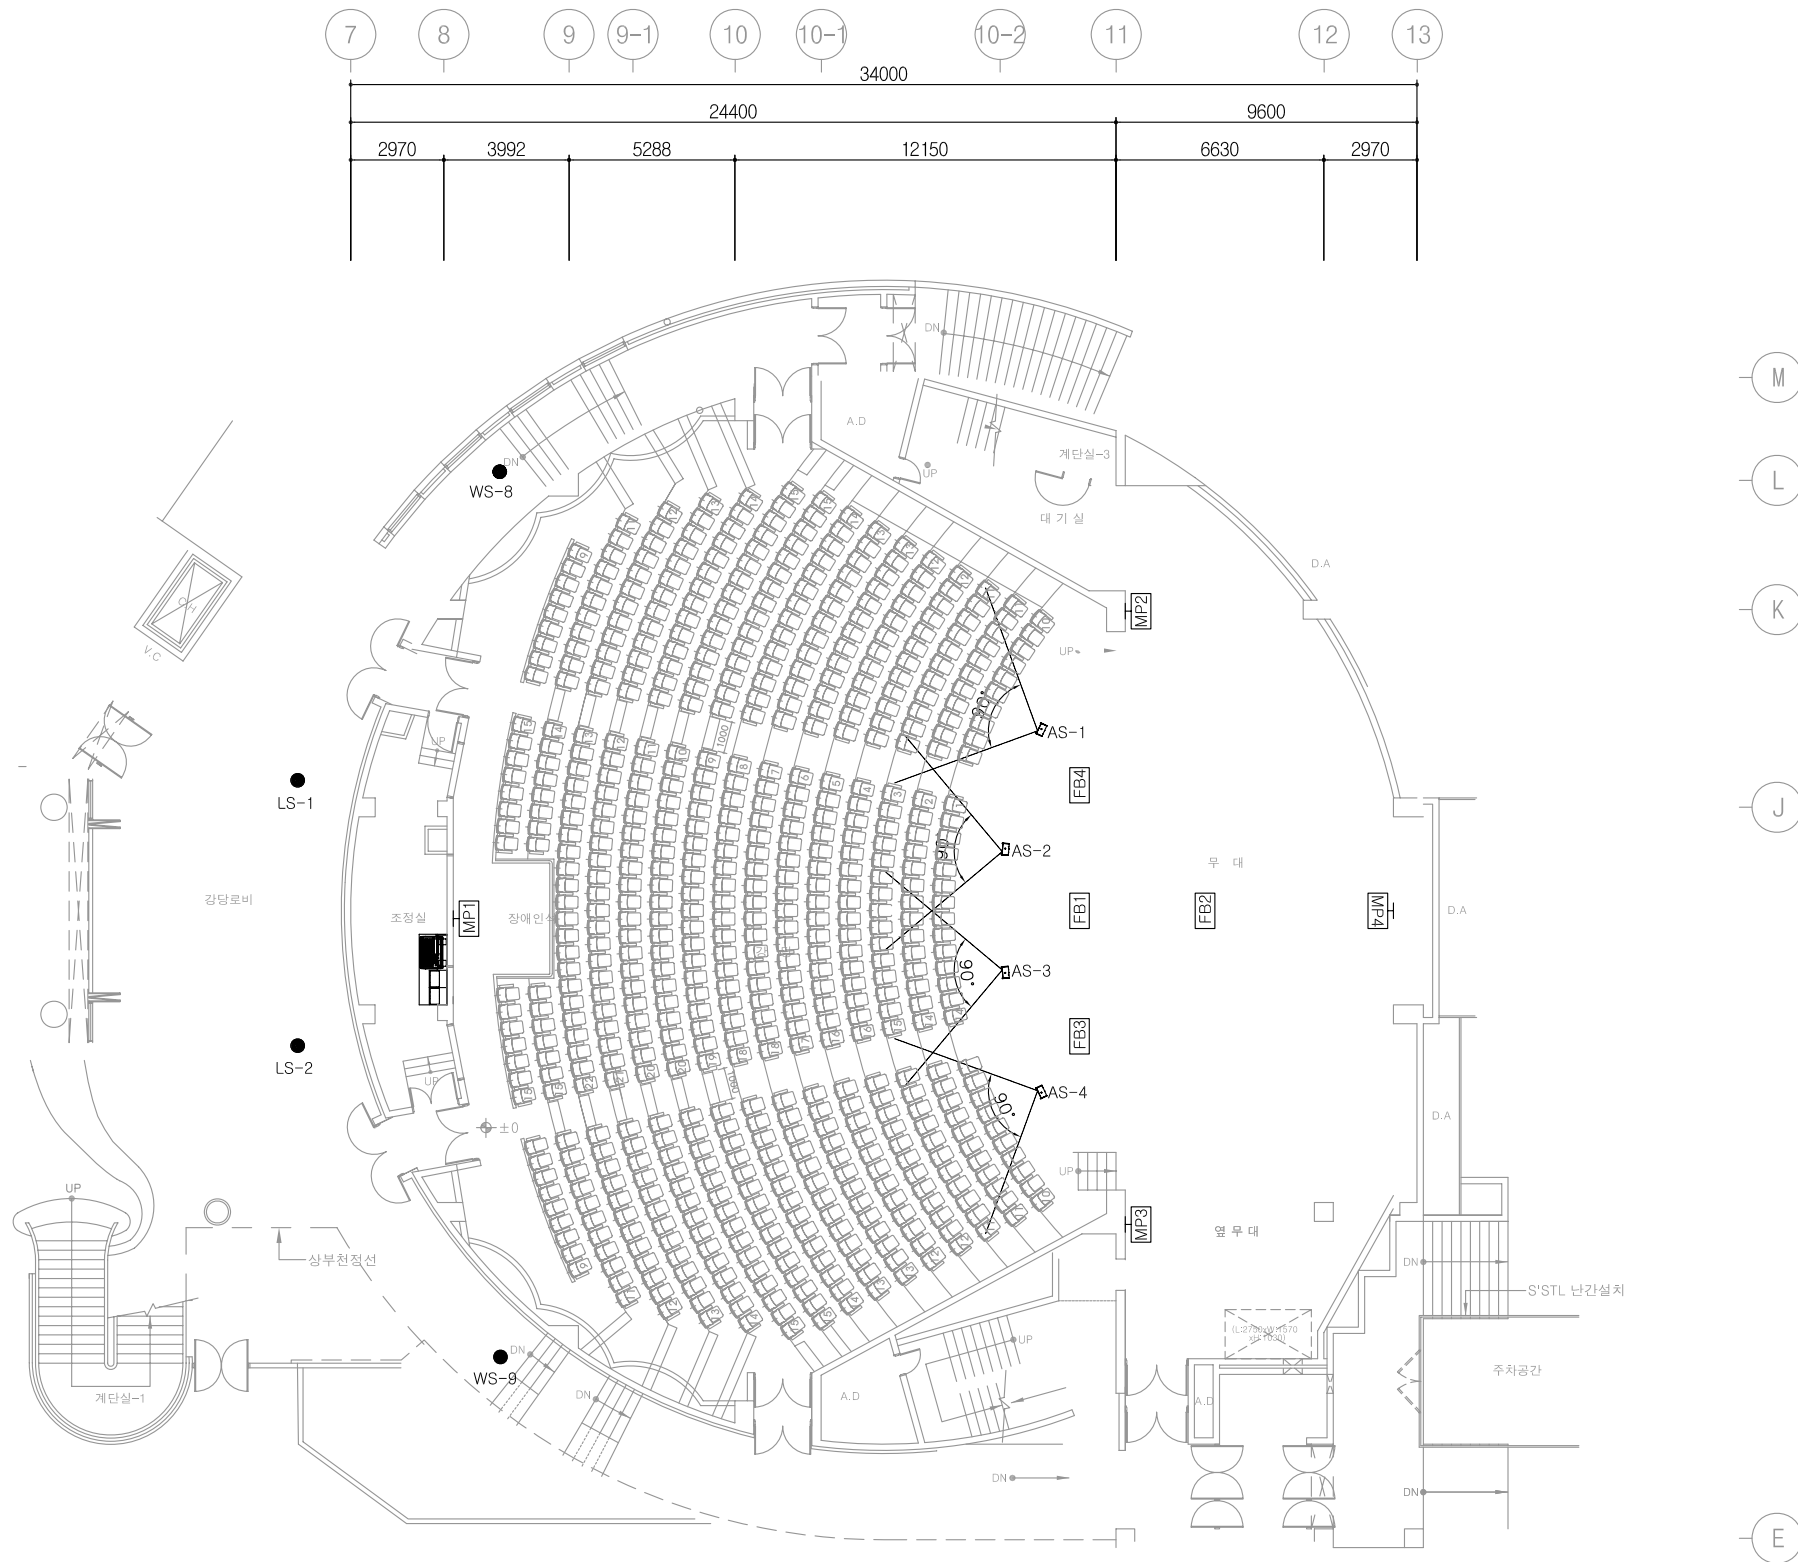

| Equipment List |                   |                                          |               |          |           |
|----------------|-------------------|------------------------------------------|---------------|----------|-----------|
| Device         | Description       | Manufacture                              | Specification | Quantity | Reference |
| MS             | SubWoofer(L,R)    | JBL                                      | VT4883        | 2        | MS-L/R    |
|                | Main Speaker(L,R) | JBL                                      | VT4886        | 9        |           |
| CS             | Center Speaker    | JBL                                      | VRX932LA      | 4        | CS        |
| AS             | Apron Speaker     | JBL                                      | Control25AV   | 1        | AS-1~4    |
| WS             | CEILING Speaker   | JBL                                      | Control24CT   | 1        | WS-1~9    |
| LS             | Lobby Speaker     | JBL                                      | Control24CT   | 1        | LS-1~5    |
| WL             | W/L Antenna       | AKG                                      | SRA2B/W       | 1        | WL-1~2    |
| Panel List     |                   |                                          |               |          |           |
| Device         | Description       | Part Number                              |               | Height   | Reference |
| FB             | Floor Box         | Mic x 4                                  |               | Floor    | FB-1~2    |
|                |                   | Mic x 2/Speaker x 2                      |               | Floor    | FB-3~4    |
| MP             | Multi Panel       | Mic x 16/Line x 16<br>MADI x 1/Power x 1 |               | F:+300   | MP-1      |
|                |                   | Mic x 8                                  |               | F:+300   | MP-2~3    |
|                |                   | Mic x 8,Line x 2/Power x 2               |               | F:+300   | MP-4      |

025  
A 03

## 콘서트홀 1층 SOUND SYSTEM LAYOUT PLAN

SCALE : 1/250