




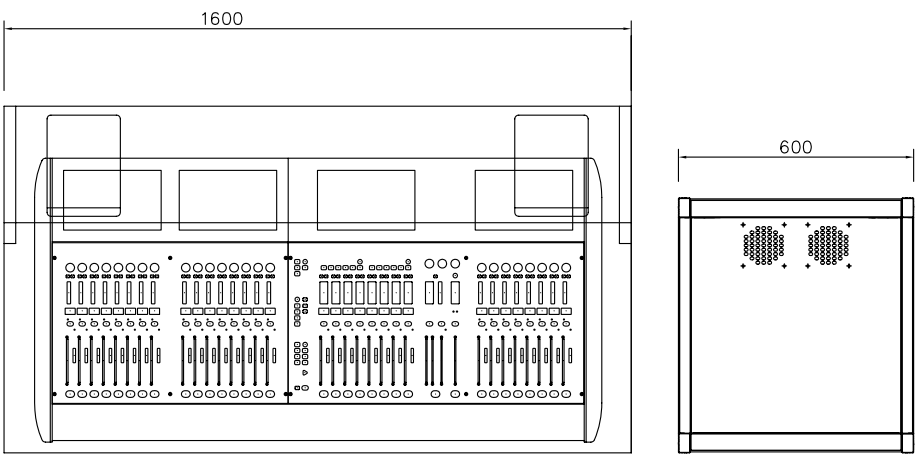

[Top View]

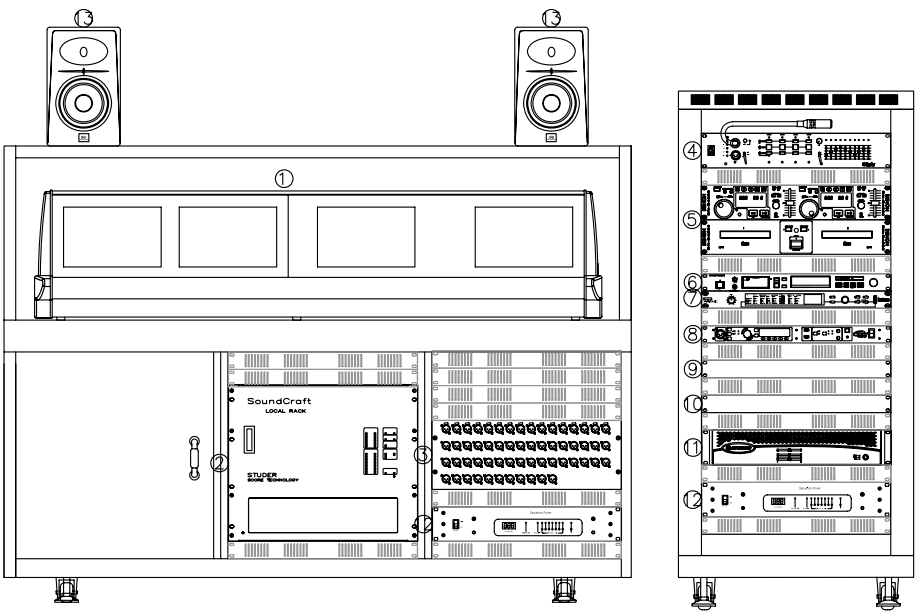

[Front View]

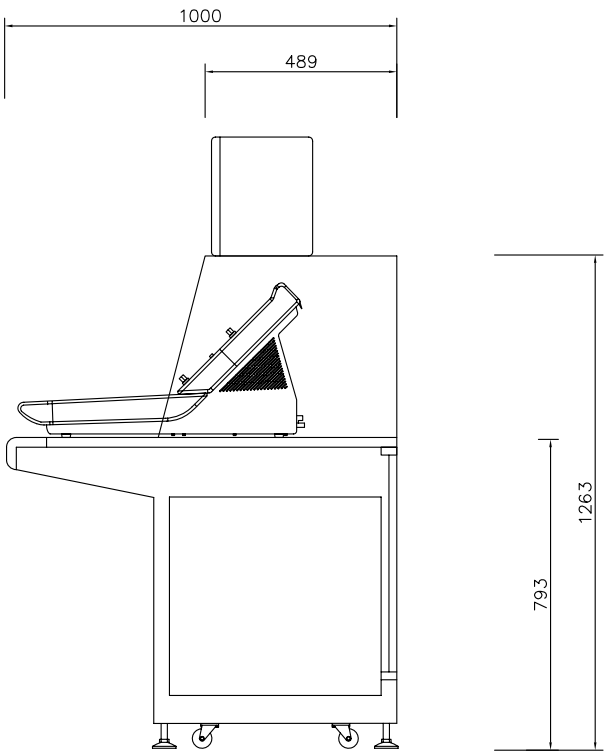

[Side View]

NO	MODEL	SPECIFICATION	EA
1	Digital Audio Mixing Console	Vi4	1
2	Local Rack		1
3	In/Out Box		1
4	Main Station	MS704	1
5	CD Player	DN-D4500	1
6	CF Recorder	PMD580	1
7	Multi Effector	MX200	1
8	Digital W/L Base Station	CM222	1
9	2-Way Radio Interface		1
10	MADI Bridge		1
11	Power Amplifier	CTs600	1
12	Power Distributor	NS8S	2
13	C/R Monitor Speaker	LSR2325P	2
	Control Console Desk		1
	Cabinet Rack	23U	1



공사명 PROJECT TITLE

연세대 백주년기념관
콘서트홀 리모델링
공사 중 정보통신공사
(음향/영상/무대)

비 고 REMARKS



서울시 마포구 월드컵로 134 관수빌딩 5층
T : 02-332-3329(10) F : 02-325-4432

등록설계번호 : 제서공E-1-043호
건축전기설비기술사 이 성 욱

제 도 DRAWN BY

검 사 CHECKED BY

협 의 CONSULT

△ / /
△ / /
승 인 APPROVED BY

축 척 SCALE

NONE

날 짜 DATE


2013. 3. 2

도면명 준공도면

콘서트홀 SOUND SYSTEM
RACK DRAWING(조정실)

도면번호 SHEET NO

A-002

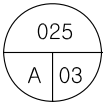

콘서트홀 SOUND SYSTEM RACK DRAWING(조정실)

SCALE : NONE